


CITY OF SAN GABRIEL CENTERLINE TIE BOOK INDEX

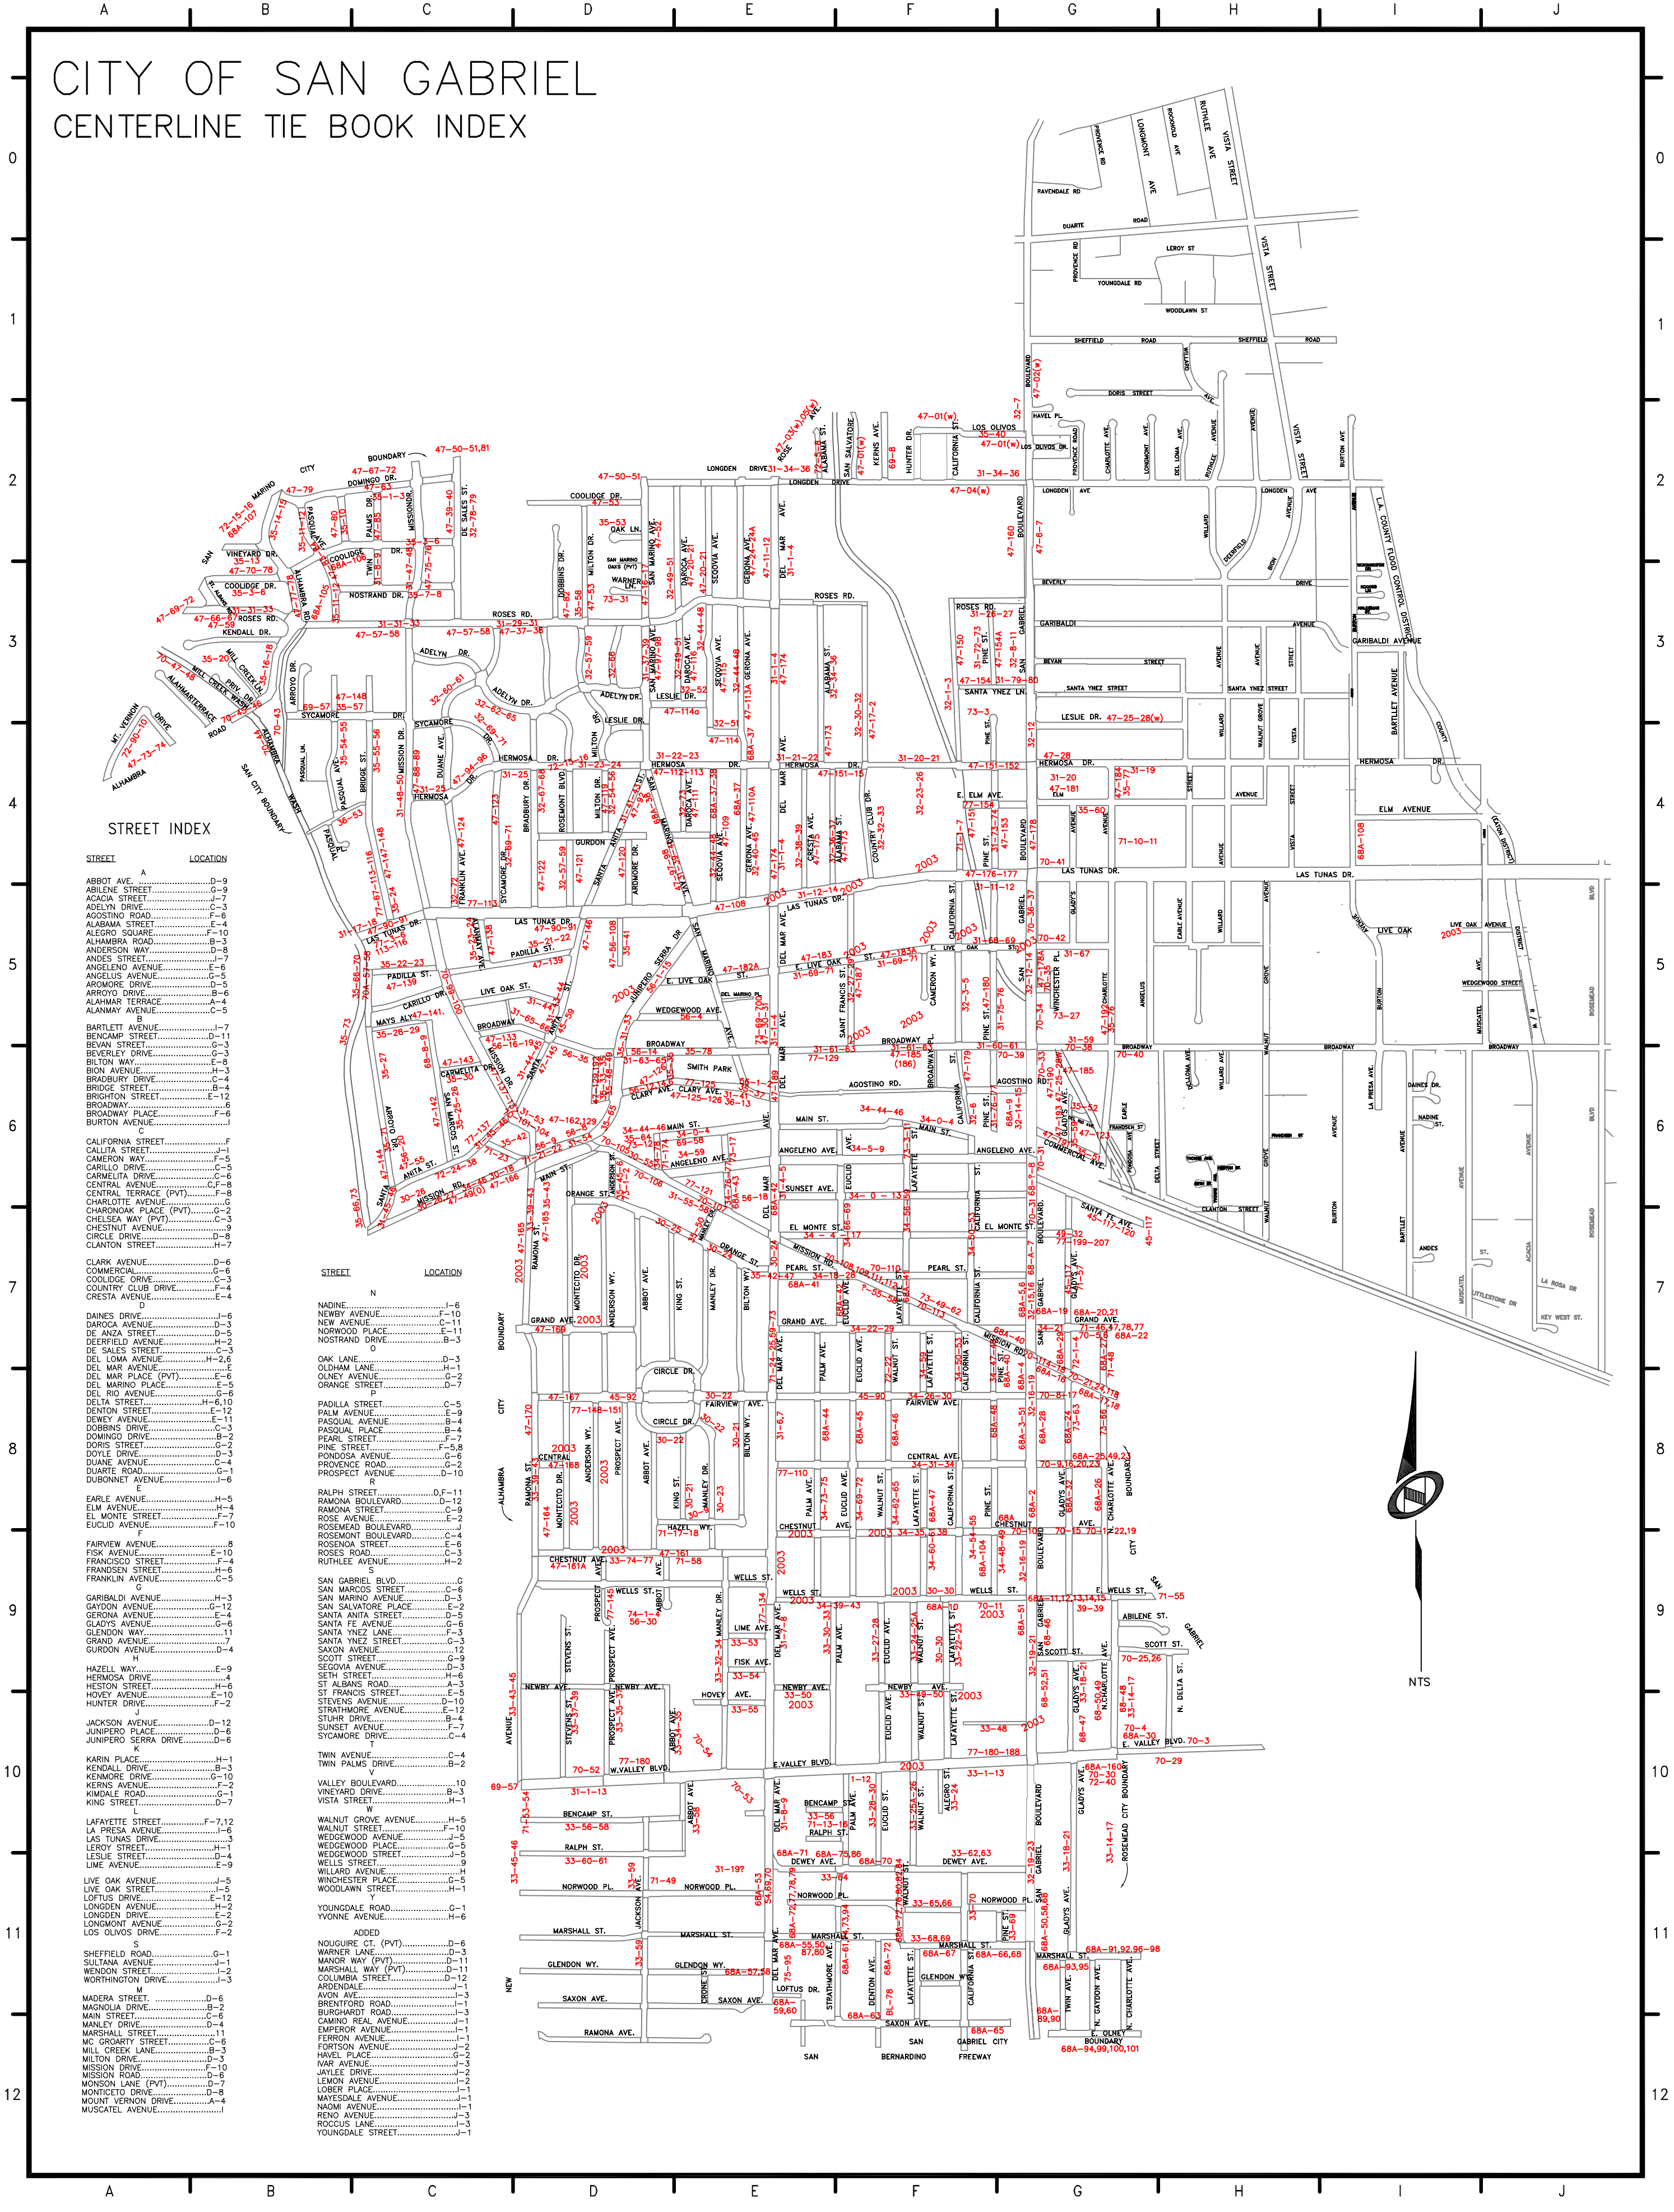

STREET INDEX

STREET LOCATION

ABBOT AVE.	D-9
ACACIA STREET	D-7
ADRIEN DRIVE	C-7
AGOSTINO ROAD	C-6
ALABAMA STREET	E-4
ALEGRO SQUARE	F-10
ALHAMBRA ROAD	B-3
ANDES STREET	D-9
ANGELENO AVENUE	F-6
ANGELUS AVENUE	F-10
ARMORE DRIVE	D-5
ARROYO DRIVE	D-4
ALHAMBRA TERRACE	A-4
ALANWAY AVENUE	C-5
BARTLETT AVENUE	D-7
BEVAN STREET	D-11
BEVERLY DRIVE	C-3
BILTON WAY	C-3
BION AVENUE	H-3
BROADWAY DRIVE	C-4
BRIGHTON STREET	E-12
BROADWAY PLACE	F-6
BURTON AVENUE	D-6
CALIFORNIA STREET	F-6
CALLITA STREET	D-11
CAMERON WAY	D-5
CARILLO DRIVE	C-5
CARMELITA DRIVE	F-10
CENTRAL AVENUE	C-8
CENTRAL TERRACE (PVT)	F-10
CHARLOTTE AVENUE	C-6
CHARONGAK PLACE (PVT)	C-2
CHELSEA WAY (PVT)	C-3
CHESTNUT AVENUE	C-3
CIRCLE DRIVE	D-10
CLANTON STREET	H-7
CLARK AVENUE	D-6
COMMERCIAL	C-6
COOLIDGE DRIVE	F-4
COUNTRY CLUB DRIVE	F-4
CRESTA AVENUE	E-4
DANES DRIVE	I-6
DARCOA AVENUE	D-3
DE ANCA STREET	C-11
DEERFIELD AVENUE	H-2
DE SALES STREET	C-3
DEL LOMA AVENUE	H-2,6
DEL MAR AVENUE	E-6
DEL MAR PLACE (PVT)	E-6
DEL MARINO PLACE	D-7
DEL RIO AVENUE	D-7
DELTA STREET	H-6,10
DENTON STREET	E-12
DENY AVENUE	E-11
DOBBS DRIVE	C-3
DOMINGO DRIVE	C-3
DORIS STREET	C-2
DOYLE DRIVE	D-3
DUANE AVENUE	D-4
DUARTE ROAD	G-1
DUBONNET DRIVE	H-6
EARLE AVENUE	H-5
ELM AVENUE	C-11
EL MONTE STREET	F-7
EUCUID AVENUE	F-10
FAIRVIEW AVENUE	D-8
FIK AVENUE	E-10
FRANCISCO STREET	F-4
FRANSDEN STREET	H-6
FRANKLIN AVENUE	C-5
GARBALDI AVENUE	H-3
GARDON AVENUE	A-4
GERONA AVENUE	E-4
SANTA FE AVENUE	G-1
GLENDON WAY	G-1
GRAND AVENUE	D-7
GURDON AVENUE	D-4
HAZELL WAY	E-9
HERMOZA DRIVE	H-6
HESTON STREET	E-10
HONEY AVENUE	E-2
HUNTER DRIVE	E-2
JACKSON AVENUE	D-12
JUNIPERO PLACE	D-6
JUNIPERO SERRA DRIVE	D-6
KARIN PLACE	H-1
KENDALL DRIVE	B-3
KENMORE DRIVE	B-3
KERN AVENUE	F-2
KINDALE ROAD	G-1
KING STREET	D-7
LAFAYETTE STREET	F-7,12
LA PRESA AVENUE	I-6
LAS TUNAS DRIVE	H-1
LERROY STREET	G-5
LESLIE STREET	D-4
LIME AVENUE	E-9
LIVE OAK AVENUE	E-5
LIVE OAK STREET	E-12
LOFTUS DRIVE	E-12
LONGMONT AVENUE	E-2
LOS OLIVOS DRIVE	F-2
SHEFFIELD ROAD	G-1
SULTANA AVENUE	D-11
WENDON STREET	D-12
WORTHINGTON DRIVE	D-12
MADRA STREET	D-6
MAGNOLIA DRIVE	B-2
MAIN STREET	C-6
MANLY DRIVE	D-4
MARSHALL STREET	D-11
MC GROWERY STREET	C-6
MILL CREEK LANE	B-3
MILTON DRIVE	D-3
MISSION DRIVE	D-10
MISSION ROAD	D-7
MISSION LANE (PVT)	D-8
MONTECITO DRIVE	D-8
MOUNT VERNON DRIVE	A-4
MUSCATEL AVENUE	I-1
NOUGHIRE CT. (PVT)	D-6
MANOR WAY (PVT)	D-11
MARSHALL WAY (PVT)	D-11
COLUMBIA STREET	D-12
ARDEALE	D-12
AVON AVENUE	D-3
BRENTFORD ROAD	I-1
BURKHARDT ROAD	I-3
CANON REAL AVENUE	I-1
EMPEROR AVENUE	I-1
FORTSON AVENUE	G-2
HANET PLACE	G-2
IAR AVENUE	G-3
JAYLEE DRIVE	G-2
LEMON AVENUE	G-2
LOBER PLACE	I-1
MATESHALE AVENUE	I-1
NAGMI AVENUE	I-1
RENO AVENUE	I-1
ROCCUS LANE	I-3
YOUNGDALE STREET	I-3

STREET LOCATION

NADINE	I-6
NEWBY AVENUE	F-10
NORWOOD PLACE	C-11
NOSTRAND DRIVE	B-3
OAK LANE	D-3
OLDHAM LANE	H-1
OLNEY AVENUE	E-6
ORANGE STREET	D-7
PADILLA STREET	C-5
PALM AVENUE	D-11
PASQUAL AVENUE	C-9
PASQUAL PLACE	H-4
PEARL STREET	F-7
PINE STREET	F-7
PONDOSA AVENUE	D-10
PROVENCE ROAD	C-3
PROSPECT AVENUE	D-10
RALPH STREET	D-11
RAMONA BOULEVARD	D-12
RAMONA STREET	C-11
ROSE AVENUE	C-9
ROSEBUD BOULEVARD	C-9
ROSEMONT BOULEVARD	C-9
ROSENDA STREET	C-6
ROSEY ROAD	C-11
RUTHLEE AVENUE	C-11
SAN GABRIEL BLVD.	C-6
SAN MARCOS STREET	C-6
SAN MARINO AVENUE	D-3
SAN SALVATORE PLACE	E-5
SANTA ANITA STREET	F-5
SANTA FE AVENUE	G-1
SANTA YNEZ LANE	F-3
SANTA YNEZ STREET	C-3
SAXON AVENUE	D-3
SCOTT STREET	H-6
SECONDA AVENUE	H-6
SETH STREET	H-6
ST ALBANS ROAD	A-3
ST FRANCIS STREET	E-5
STRAITHMORE AVENUE	D-10
STURM DRIVE	E-12
SUNSET AVENUE	F-7
SYCAMORE DRIVE	C-4
TWIN AVENUE	C-4
TWIN PALMS DRIVE	B-1
VALLEY BOULEVARD	B-10
VINEYARD DRIVE	B-10
VISTA STREET	H-1
WALNUT GROVE AVENUE	H-5
WALNUT STREET	F-10
WEDGEWOOD AVENUE	H-1
WEDGEWOOD PLACE	G-5
WEDGEWOOD STREET	G-5
WELLS STREET	H-9
WILLARD AVENUE	H-9
WINCHESTER PLACE	E-5
WOODLAWN STREET	H-1
YOUNGDALE ROAD	G-1
YVONNE AVENUE	H-6

ADDED

NOUGHIRE CT. (PVT)	D-6
MANOR WAY (PVT)	D-11
MARSHALL WAY (PVT)	D-11
COLUMBIA STREET	D-12
ARDEALE	D-12
AVON AVENUE	D-3
BRENTFORD ROAD	I-1
BURKHARDT ROAD	I-3
CANON REAL AVENUE	I-1
EMPEROR AVENUE	I-1
FORTSON AVENUE	G-2
HANET PLACE	G-2
IAR AVENUE	G-3
JAYLEE DRIVE	G-2
LEMON AVENUE	G-2
LOBER PLACE	I-1
MATESHALE AVENUE	I-1
NAGMI AVENUE	I-1
RENO AVENUE	I-1
ROCCUS LANE	I-3
YOUNGDALE STREET	I-3



NTS